

revisions			
no.	date	description	by
1	4/16/13	STOP MARKINGS/ADD NOTES	CRL
2	5/13/13	REVISED WATER VALVE LOCATION	CRL
3	6/4/13	FIRE ACCESS BLUE	CRL
4	11/1/17	PREST HOUSE	CRL
5	1/11/23	UPDATE TITLE BLOCK	TW

LEGEND	
	GAS VALVE
	GAS METER
	WATER VALVE
	HYDRANT
	WATER METER
	CURB STOP
	DRAINAGE MH
	CURB INLET
	LAWN INLET
	SANITARY MH
	CLEANOUT
	BOLLARD
	SIGN
	LIGHT
	MAIL BOX
	GUY WIRE
	UTILITY POLE
	ELECTRIC MH
	CONIFEROUS TREE
	DECIDUOUS TREE
	FENCE
	GATE POST
	WATER LINE
	GAS LINE
	ELECTRIC LINE
	SANITARY LINE
	OVERHEAD WIRES

**The Reynolds Group Inc.**  
 State of New Jersey  
 Certificate of Authorization  
 Number 24CA 27369200  
 Number 21MH0004300  
 F. Mitchell Ardman, P.E., P.P.  
 Jeffrey D. Reynolds, P.L.A.


**HOWARD C. LOPSHIRE**  
 PROFESSIONAL LAND SURVEYOR  
 NJ LIC. No. 24GS02880300

**NOTES**

- THIS SURVEY IS VALID ONLY WHEN EMBOSSED SEAL IS AFFIXED HERETO.
- THE REYNOLDS GROUP, INC. AND/OR ITS EMPLOYEES ARE NOT LIABLE FOR ERRORS WITHIN, AND/OR OMISSIONS FROM ANY DOCUMENTS PROVIDED BY OTHERS.
- FIELD WORK DATES: 2/12/09, 6/28/12 & 10/30/17.

**REFERENCES**

- MAP ENTITLED "JAIN CENTER, BLOCK 468.07, LOT 45, FRANKLIN TOWNSHIP, SOMERSET COUNTY, NEW JERSEY, GRADING & UTILITY PLAN," PREPARED BY THE REYNOLDS GROUP, INC. DATED DECEMBER 8, 2005.

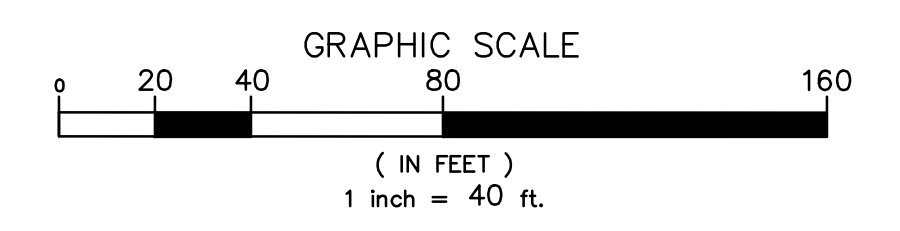

drawing title	
<b>RECORD AS-BUILT PLAN</b> of <b>BLOCK 468.07, LOT 45</b> TOWNSHIP OF FRANKLIN SOMERSET COUNTY, NEW JERSEY	
job number	drawing number
00-001	
scale	<b>R-1</b>
checked by	
HER	
drawn by	
CRL/JMCM/TW	
date	sheet 1 of 1
12/20/12	

S:\LOCAL\_3D SURVEY PROJECTS\2000\2001-01-20 (JAIN CENTER PREST HOUSE)\\_CAD DRAWINGS\20-01-20 RECORD AS-BUILT SURVEY (1-11-2023).DWG (1/22/23)